24600 SF Total

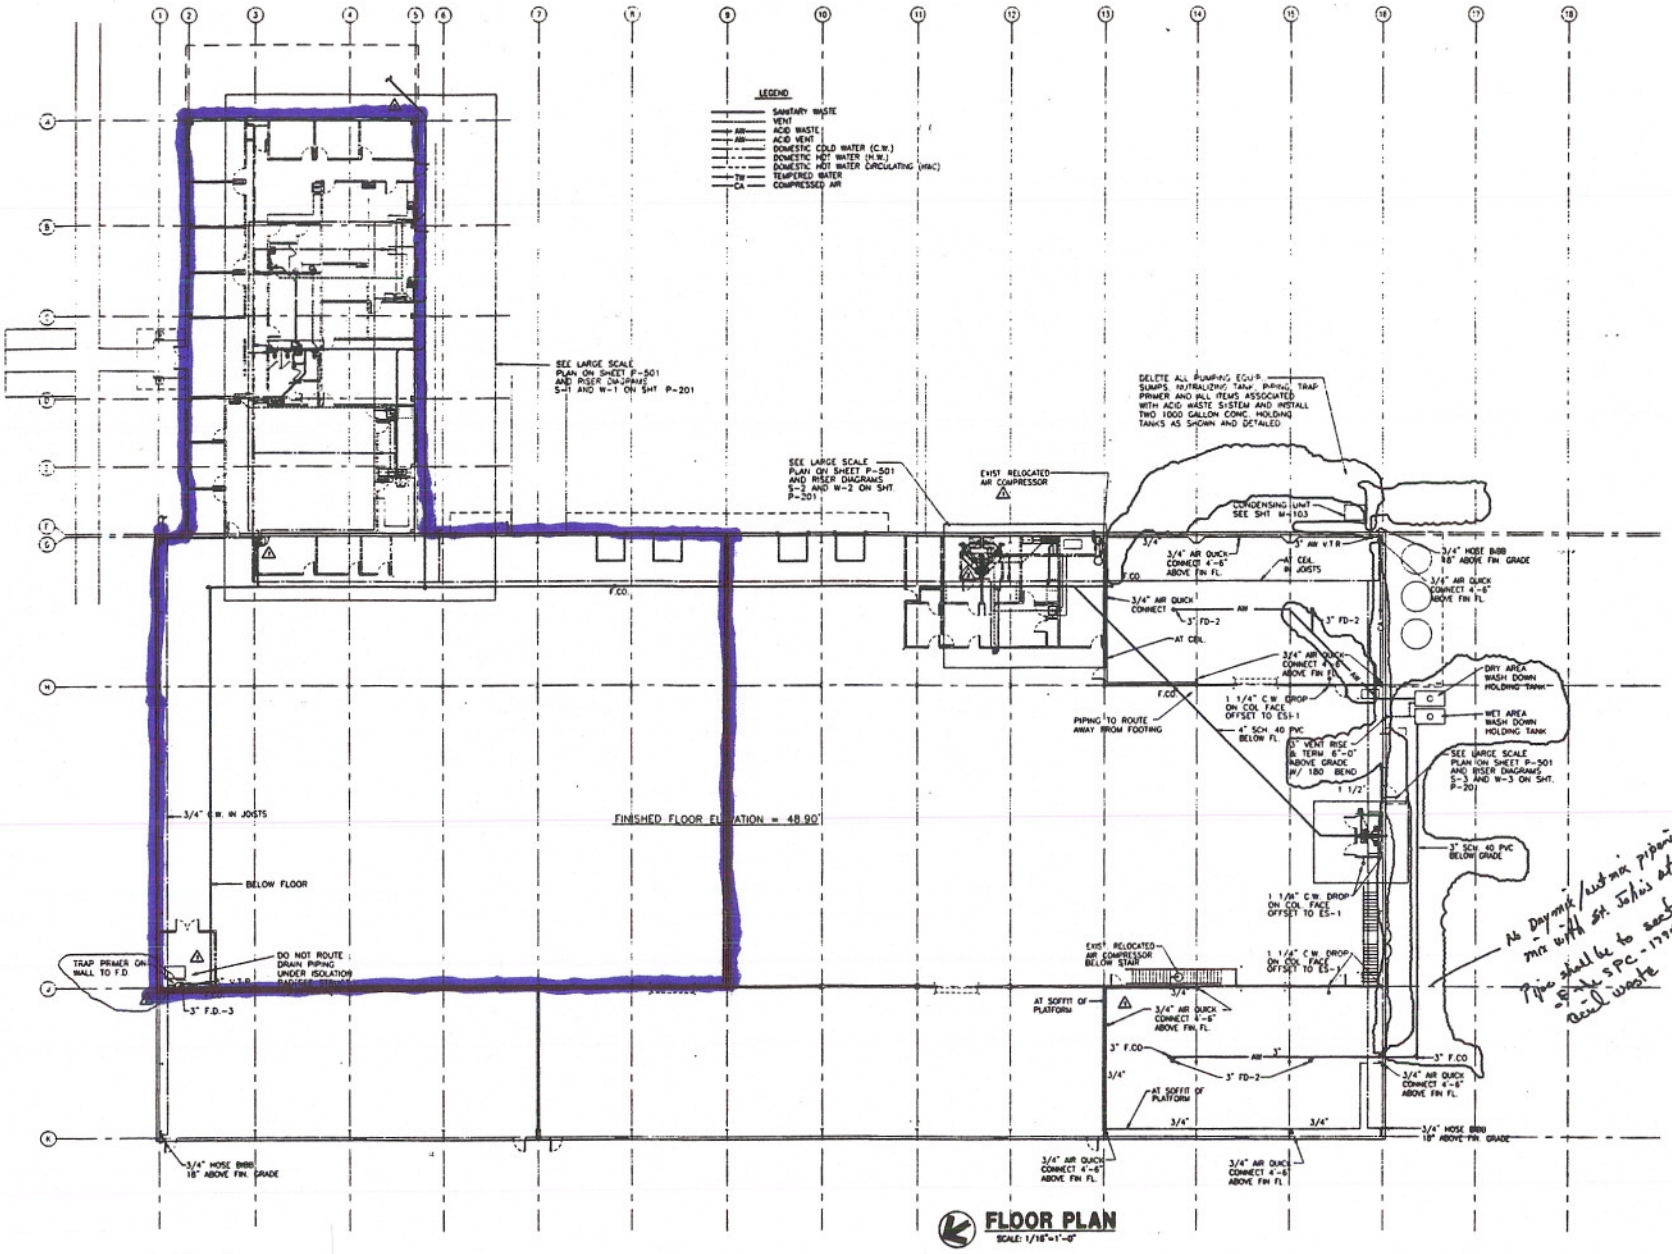

FLOOR PLAN
SCALE: 1/16"=1'-0"

Exhibit A

6600 SF Office

18000 SF Warehouse

RS&H
Architectural, Engineering, Planning and Environmental Services

Reynolds, Smith and Hills, Inc.
4651 Salisbury Road
Jacksonville, Florida 32256
904-296-2000 FAX 904-279-2491
www.rsandh.com
FL.Cert.Lic. AAC001286 · EB0000639 · LC0000219

PROTEAM PRODUCTS

PROTEAM PRODUCTS
THE JOHN GIRVAN CO., INC.
JACKSONVILLE, FLORIDA

PRICE CONTRACTING, INC.
6299-5 POWERS AVENUE
JACKSONVILLE, FLORIDA

CONSULTANTS

REVISIONS

NO.	DESCRIPTION	DATE
1	PERMIT SET	07/02/99
2	REVIEW COMMENT (PRIMERS)	09/03/99

DATE ISSUED: 7-2-99
REVIEWED BY: REO
DRAWN BY: RLM
DESIGNED BY: RLM

AEP PROJECT NUMBER
501-9448-001

PROJECT INC
© 1997 REYNOLDS, SMITH AND HILLS INC

SHEET TITLE
PLUMBING FLOOR PLAN

OFFICE COPY OFFICE COPY
OFFICE COPY OFFICE COPY

SHEET NUMBER
P101

PHASE II
100% SUBMITTAL

12/21/99